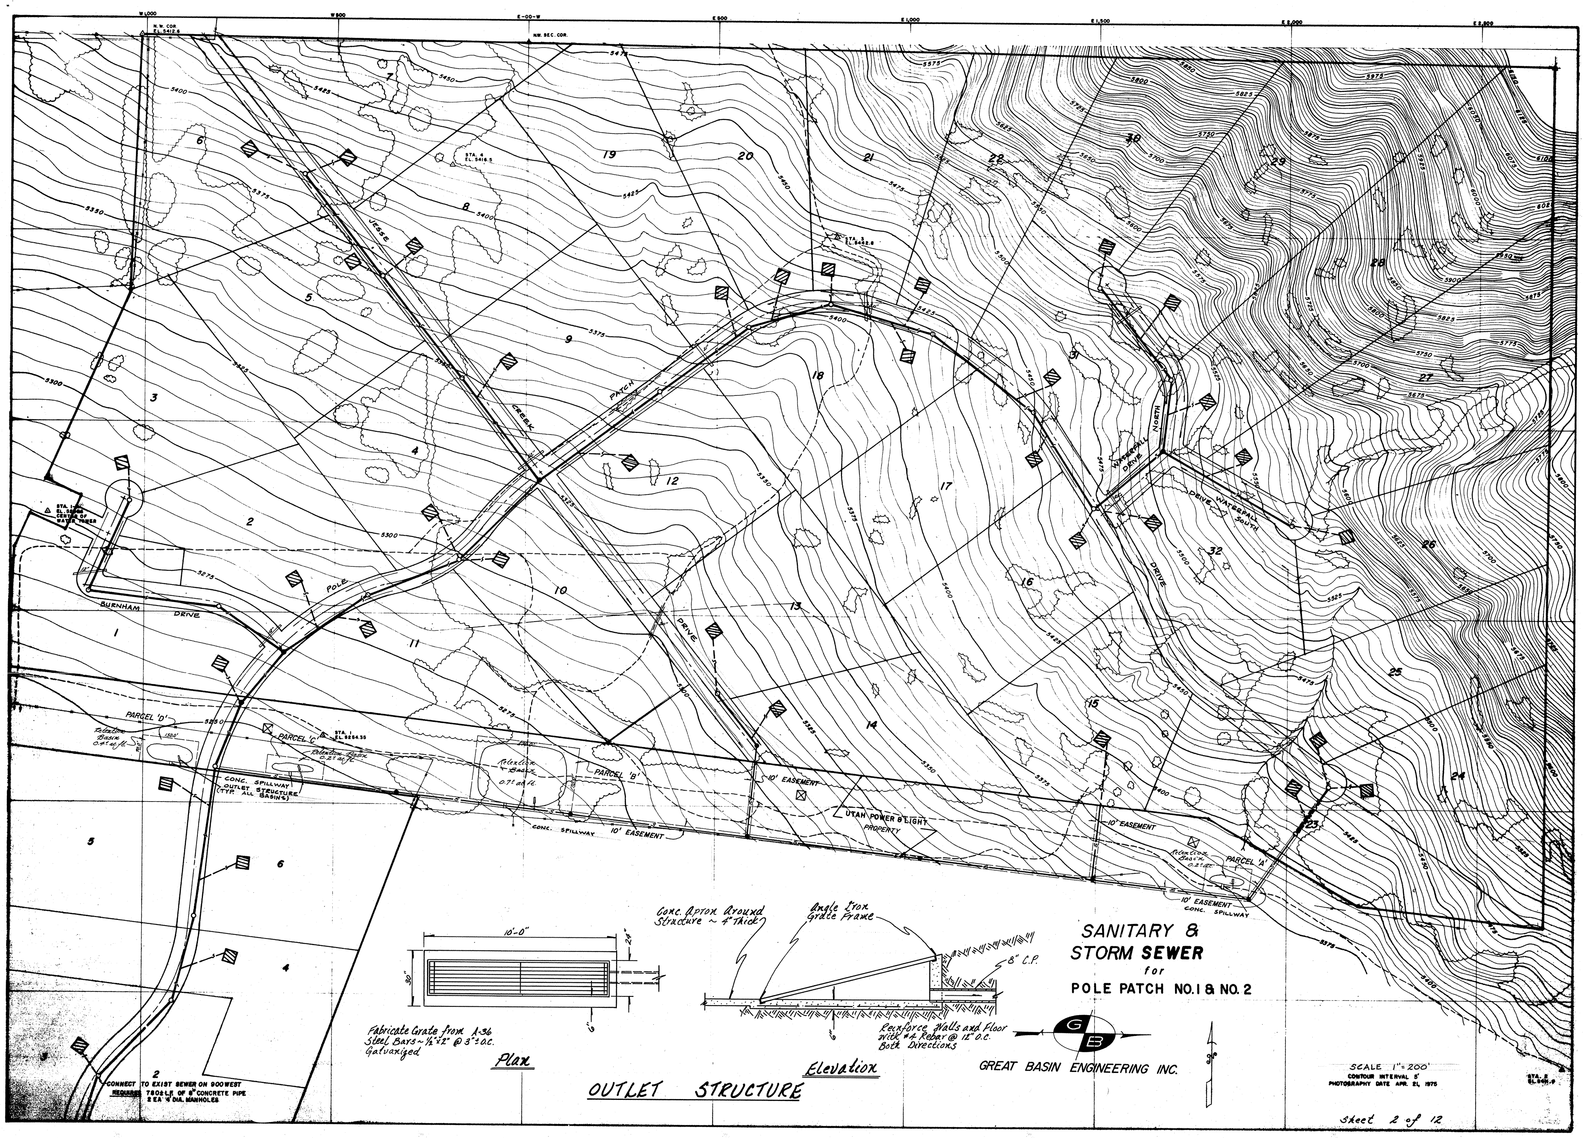

SANITARY & STORM SEWER for POLE PATCH NO. 1 & NO. 2

GREAT BASIN ENGINEERING INC.

SCALE 1" = 200'
CONTOUR INTERVAL 5'
PHOTOGRAPHY DATE APR. 21, 1975

Sheet 2 of 12

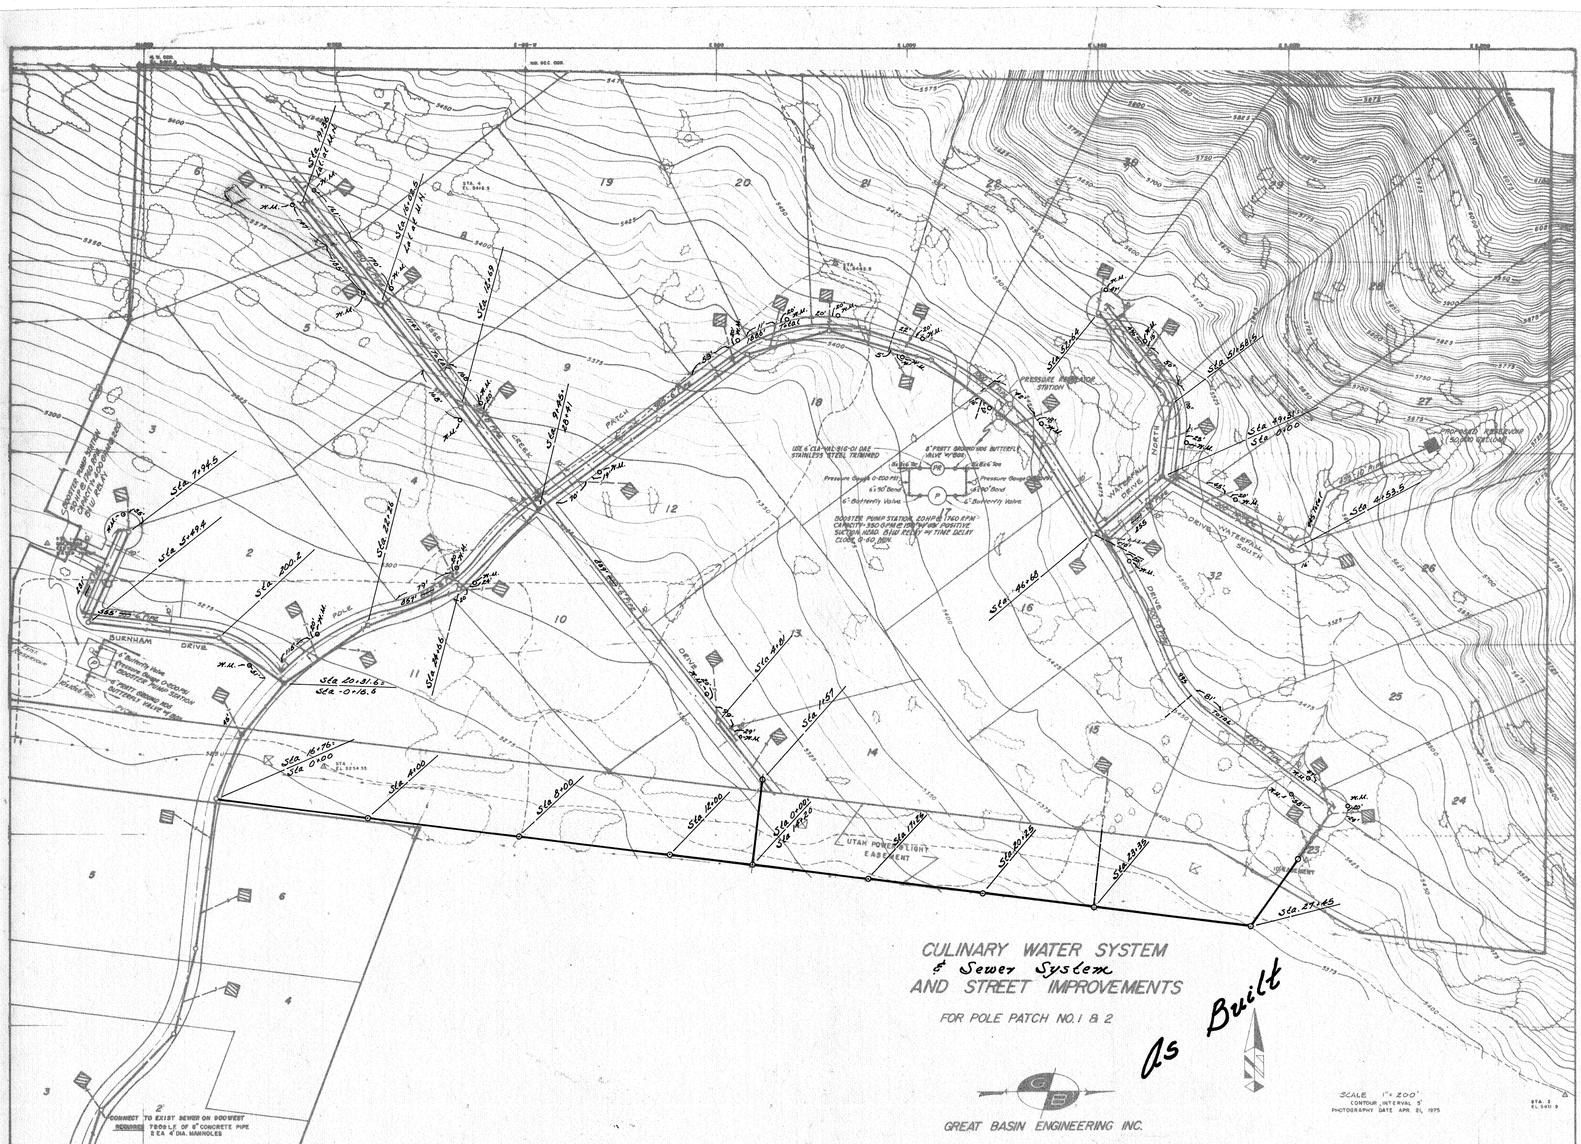

CULINARY WATER SYSTEM & Sewer System AND STREET IMPROVEMENTS

FOR POLE PATCH NO. 1 & 2

As Built

GREAT BASIN ENGINEERING INC.

SCALE 1" = 200'
CONTOUR INTERVAL 5'
PHOTOGRAPHY DATE APR. 21, 1975

Sheet 1 of 12

AERIAL PHOTOGRAPHY BY AERIAL SURVEYS, INC - SALT LAKE CITY, UTAH - 8097